



© Crown copyright and database rights 2023 Ordnance Survey 100019422  
 You are not permitted to copy, sub-license, distribute or sell any of this data to third parties in any form.  
 Produced by Staffordshire County Council, 2023.

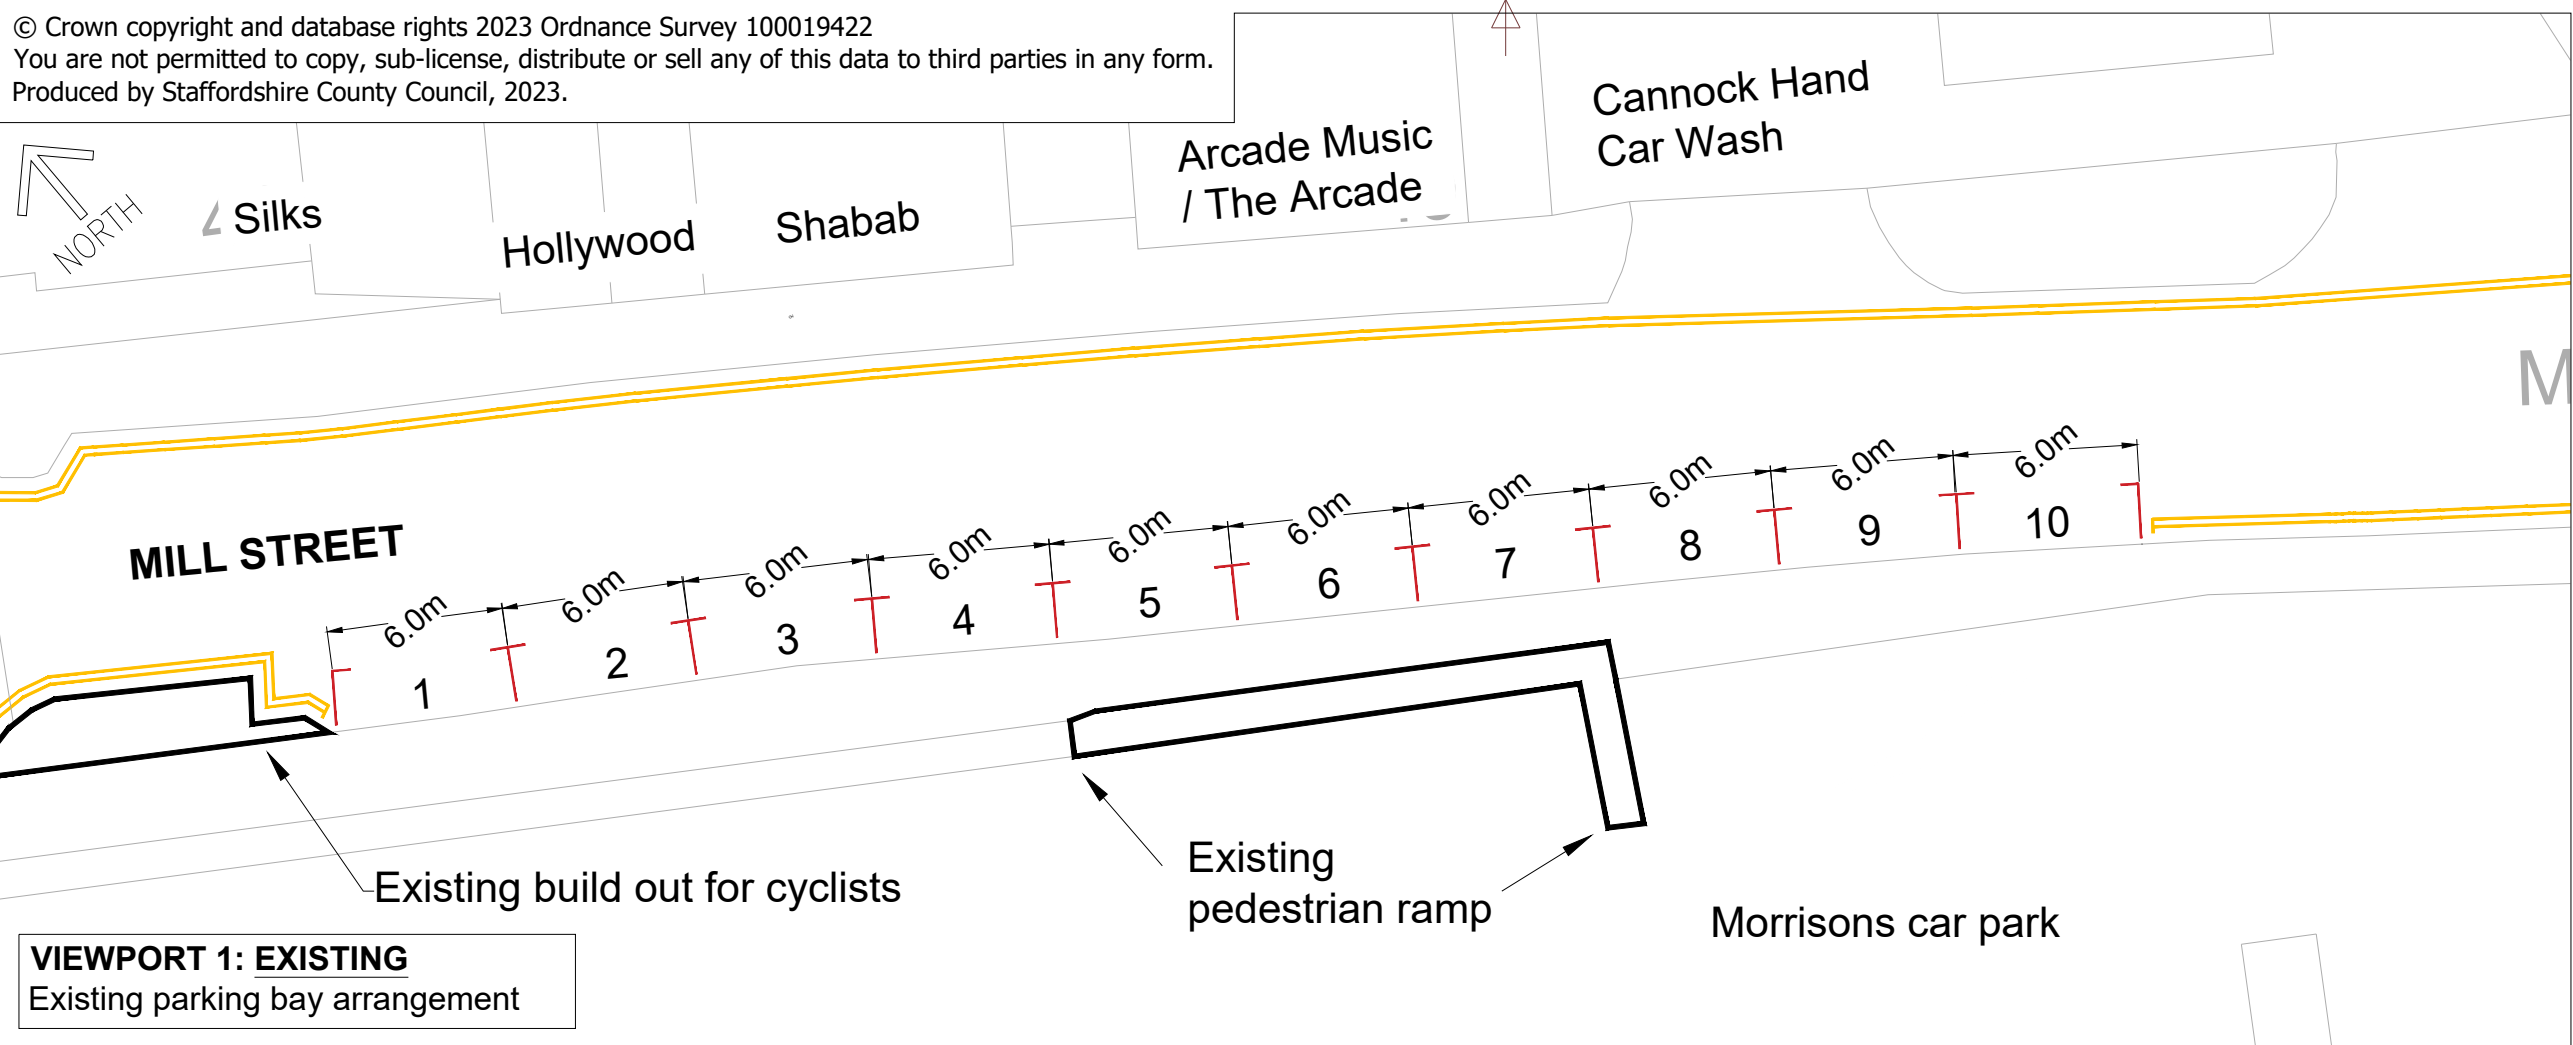

**VIEWPORT 1: EXISTING**  
 Existing parking bay arrangement

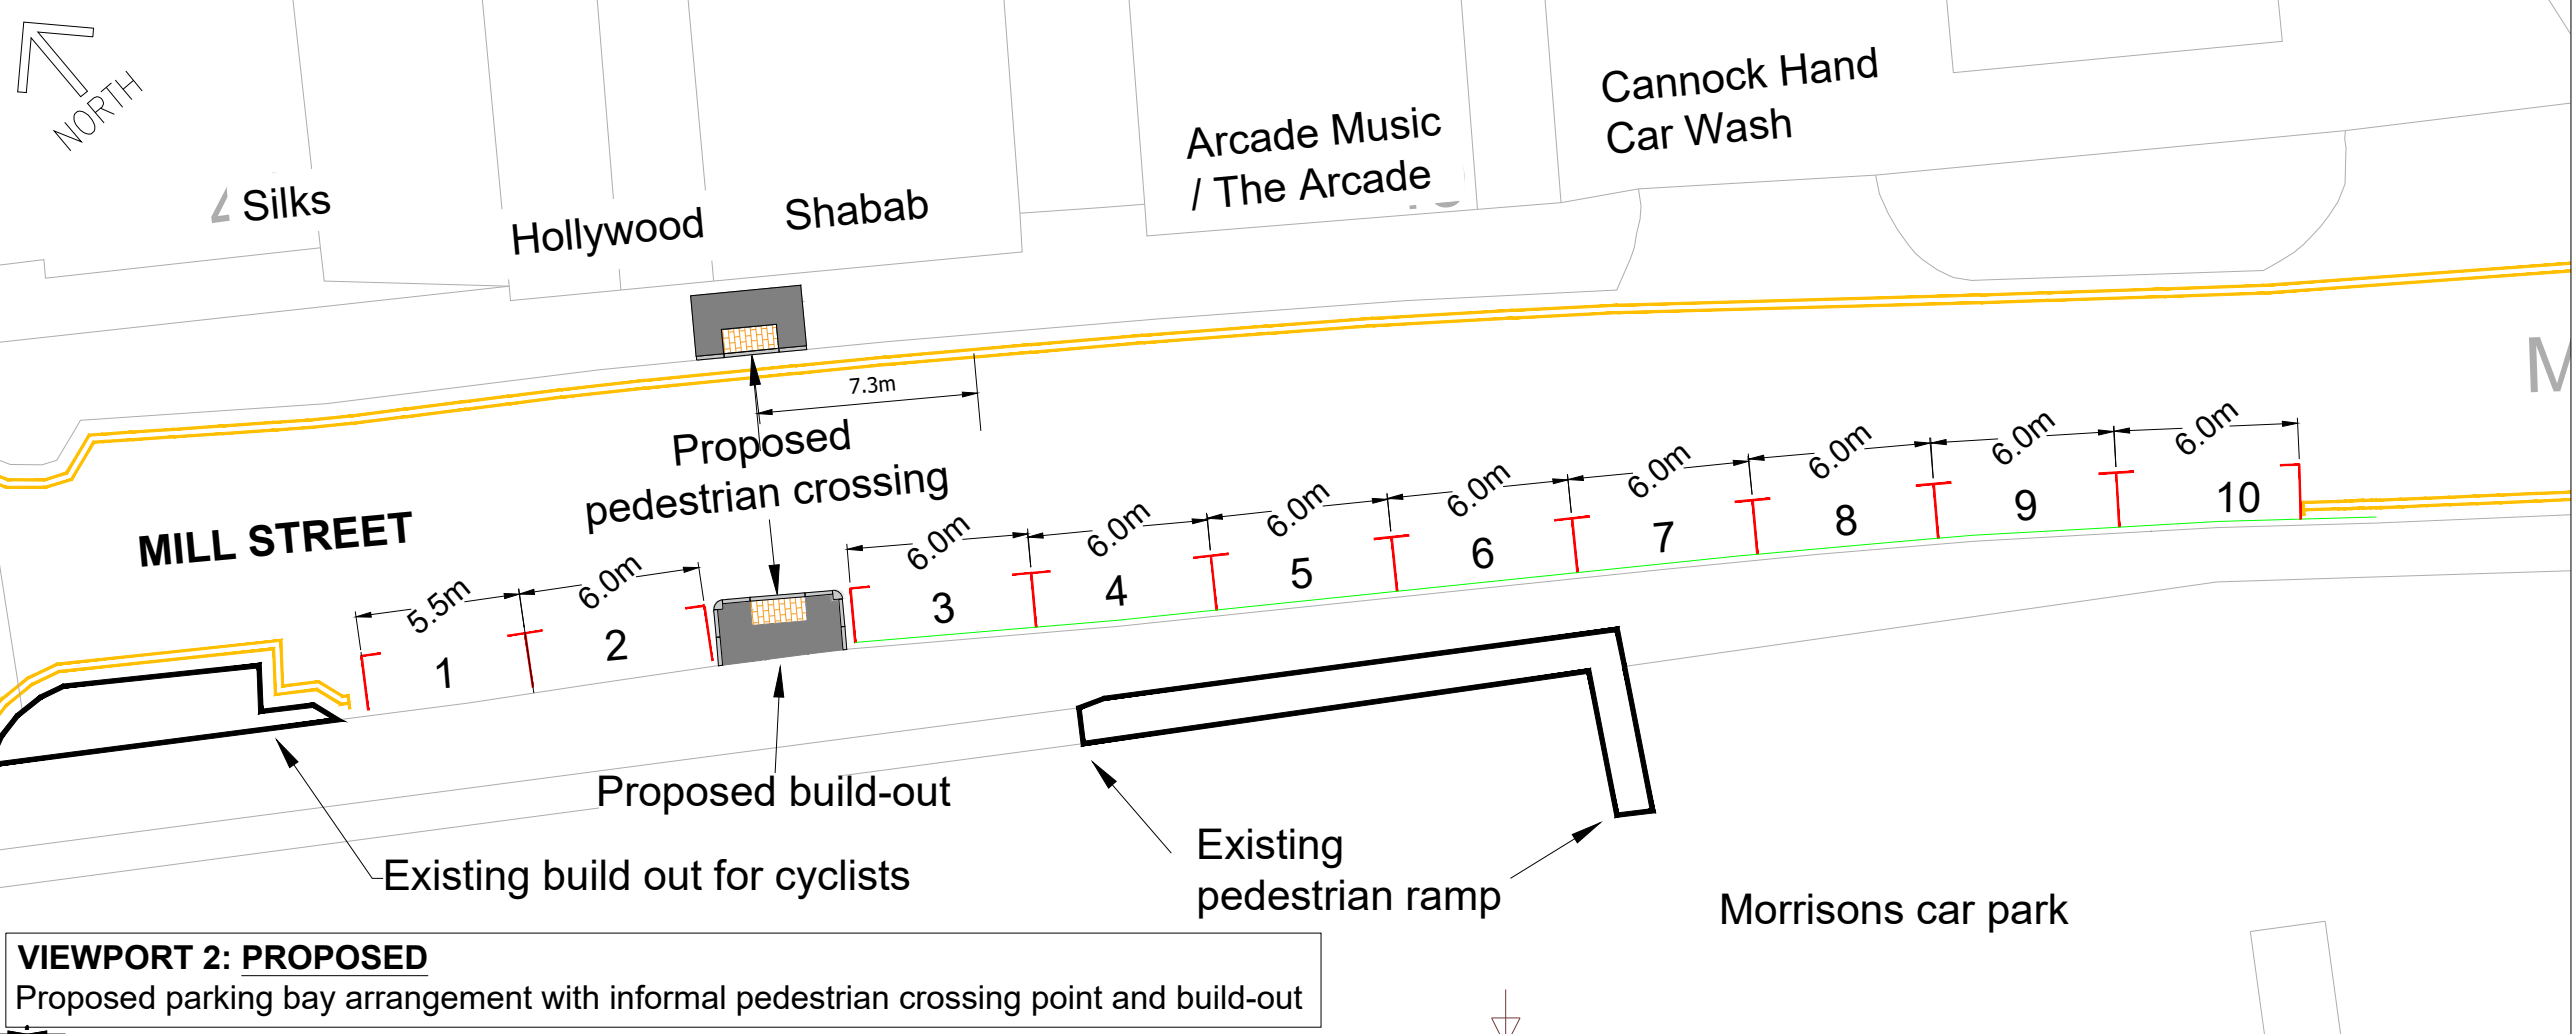

**VIEWPORT 2: PROPOSED**  
 Proposed parking bay arrangement with informal pedestrian crossing point and build-out

**KEY**

- 'No waiting at any time' restrictions (double yellow lines)
- Parking bays (Monday - Saturday, 8am - 6pm, 40 minutes - No return within 4 hours)

**NOTES**

- No changes proposed to road markings not shown on this drawing.

Rev	Detail	By	Date
P1	Proposed pedestrian crossing moved	RS	05/09/2023

Revisions

Original Version	Preliminary	For comment	For tender	For construction	As constructed	Other
						<input checked="" type="checkbox"/>
Drawn: MJ						
Design: MJ						
Date: August 2023						

Checked by:-

Approved by:- (Drawing NOT approved if this box is empty)



Project Name  
 LUF2 Cannock - Mill Street

Drawing Title  
 Highways  
 TRO Consultation

Grid reference : 398297E, 310079N
Original Drawing Size : A3 Dimensions : m
Scale : 1:250 Copyright © Amey
Drawing No D1203A-SK05
Rev P1

File Name: \\staffordshire.gov.uk\storage\dsd-data\Highways\Integrated Transport\LUF2 - Cannock D1203A\3 CAD\Disciplines\1 - WIP\1 Live Drgs\D1203A-SK05 - Mill Street TRO Consultation P1.dwg  
 Layout Name: SCC-Amey A3